

Quality Control

P.

DQA: _____ Date: _____

WORK ORDER NON-CONFORMANCE / UPDATE

QA Closed: _____ Date: _____

Work Order update only



Work Order: <u>148006</u> Part No. <u>D3594-044</u> NCR No. _____	DISPOSITION Rework ☒ Scrap ☐ Use-as-is ☐ Suspected Unapproved ☐	AGAINST DEPARTMENT/PROCESS <table style="width:100%; border: none;"> <tr> <td style="border: none;">Skid-tube ☐</td> <td style="border: none;">Cross tube ☐</td> <td style="border: none;">Water Jet ☐</td> <td style="border: none;">Engineering ☐</td> </tr> <tr> <td style="border: none;">Machining ☐</td> <td style="border: none;">Small Fab ☐</td> <td style="border: none;">Prod. Eng. Coord. ☐</td> <td style="border: none;">Quality ☐</td> </tr> <tr> <td style="border: none;">Thermoforming ☐</td> <td style="border: none;">Finishing ☐</td> <td style="border: none;">Rec/Store/Packaging ☐</td> <td style="border: none;">Other ☐</td> </tr> <tr> <td style="border: none;">Large Fab ☐</td> <td style="border: none;">Composite ☐</td> <td style="border: none;">Supplier ☐</td> <td style="border: none;"></td> </tr> </table>				Skid-tube ☐	Cross tube ☐	Water Jet ☐	Engineering ☐	Machining ☐	Small Fab ☐	Prod. Eng. Coord. ☐	Quality ☐	Thermoforming ☐	Finishing ☐	Rec/Store/Packaging ☐	Other ☐	Large Fab ☐	Composite ☐	Supplier ☐	
Skid-tube ☐	Cross tube ☐	Water Jet ☐	Engineering ☐	
Machining ☐	Small Fab ☐	Prod. Eng. Coord. ☐	Quality ☐	
Thermoforming ☐	Finishing ☐	Rec/Store/Packaging ☐	Other ☐	
Large Fab ☐	Composite ☐	Supplier ☐	
Date: <u>16/7/13</u>	Step #: <u>100</u>	QTY Effective: _____		MRB (QSI042) Approval DAS 12 9-89 <u>16/7/13</u>	
Description Work Order Deviation		Disposition		Completed By <u>DL</u> <u>17/03/13</u> Lead hand / Supervisor Approval Verification DAS 9 9-89 <u>16.03.13</u> QC / QA Coordinator Approval DAS 9 9-89 <u>17-03-13</u>	
<u>Bel requires modified doublers.</u>		<u>MAKE PER MARKED UP DWG.</u> <u>Minor change.</u>	
Root Cause <table style="width:100%; border: none;"> <tr> <td style="border: none;">Environment ☐</td> <td style="border: none;">No Re-verification ☐</td> </tr> <tr> <td style="border: none;">Design ☒</td> <td style="border: none;">Operator ☐</td> </tr> <tr> <td style="border: none;">Doc/Data ☐</td> <td style="border: none;">Offset/Setup ☐</td> </tr> <tr> <td style="border: none;">Equip/Tooling ☐</td> <td style="border: none;">Supplier ☐</td> </tr> <tr> <td style="border: none;">Handling/Pre ☐</td> <td style="border: none;">Training ☐</td> </tr> <tr> <td style="border: none;">Material ☐</td> <td style="border: none;">Use for Testing ☐</td> </tr> <tr> <td style="border: none;">Internal Transport ☐</td> <td style="border: none;">Poor Information ☐</td> </tr> <tr> <td style="border: none;">Tribal Knowledge ☐</td> <td style="border: none;">Rushing ☐</td> </tr> <tr> <td style="border: none;">LOA ☐</td> <td style="border: none;">Product Improvement ☐</td> </tr> <tr> <td style="border: none;">Substation ☐</td> <td style="border: none;">Process Improvement ☐</td> </tr> <tr> <td style="border: none;">Past Expiry Date ☐</td> <td style="border: none;">Manufacturing Process ☐</td> </tr> <tr> <td style="border: none;">Misidentified ☐</td> <td style="border: none;">Past Due ☐</td> </tr> </table>		Environment ☐	No Re-verification ☐	Design ☒	Operator ☐	Doc/Data ☐	Offset/Setup ☐	Equip/Tooling ☐	Supplier ☐	Handling/Pre ☐	Training ☐	Material ☐	Use for Testing ☐	Internal Transport ☐	Poor Information ☐	Tribal Knowledge ☐	Rushing ☐	LOA ☐	Product Improvement ☐	Substation ☐	Process Improvement ☐	Past Expiry Date ☐	Manufacturing Process ☐	Misidentified ☐	Past Due ☐	FAULT CATEGORY <table style="width:100%; border: none;"> <tr> <td style="border: none;">Pressure/Forced ☐</td> <td style="border: none;">Temperature/Cure ☐</td> <td style="border: none;">Power Loss/Surge ☐</td> <td style="border: none;">Positioned Wrong ☐</td> </tr> <tr> <td style="border: none;">Bending ☐</td> <td style="border: none;">Set-up ☐</td> <td style="border: none;">Folio/Program ☐</td> <td style="border: none;">Outside Dimensions ☐</td> </tr> <tr> <td style="border: none;">Centre Not Concentric ☐</td> <td style="border: none;">BOM/Route ☐</td> <td style="border: none;">Grain ☐</td> <td style="border: none;">Over/Under tolerance ☐</td> </tr> <tr> <td style="border: none;">Cracks ☐</td> <td style="border: none;">Broken/Damage/Defect ☐</td> <td style="border: none;">Weld ☐</td> <td style="border: none;">Part Incorrect ☐</td> </tr> <tr> <td style="border: none;">Crimp/Kink/Ripple/Wave ☐</td> <td style="border: none;">Inspection Incomplete/Unqualified ☐</td> <td style="border: none;">Wrong Stock Pulled ☐</td> <td style="border: none;">Part Lost/Missing ☐</td> </tr> <tr> <td style="border: none;">Cuffs ☐</td> <td style="border: none;">Contamination ☐</td> <td style="border: none;">Out of Sequence ☐</td> <td style="border: none;">Part Moved ☐</td> </tr> <tr> <td style="border: none;">Crushing ☐</td> <td style="border: none;">Countersink ☐</td> <td style="border: none;">Off-set ☐</td> <td style="border: none;">Drawing ☐</td> </tr> <tr> <td style="border: none;">Heat Treat ☐</td> <td style="border: none;">Cut Too Short ☐</td> <td style="border: none;">Mislabeled ☐</td> <td style="border: none;">Finish ☐</td> </tr> <tr> <td style="border: none;">Wave/Twist in Tube ☐</td> <td style="border: none;">Instructions Incomplete/Unclear ☐</td> <td style="border: none;">Fit/Function ☐</td> <td style="border: none;">Misread ☐</td> </tr> <tr> <td style="border: none;">Marks/Chatter ☐</td> <td style="border: none;">Drill Holes ☐</td> <td style="border: none;">Misaligned/off center ☐</td> <td style="border: none;">Turning Sequence ☐</td> </tr> </table>				Pressure/Forced ☐	Temperature/Cure ☐	Power Loss/Surge ☐	Positioned Wrong ☐	Bending ☐	Set-up ☐	Folio/Program ☐	Outside Dimensions ☐	Centre Not Concentric ☐	BOM/Route ☐	Grain ☐	Over/Under tolerance ☐	Cracks ☐	Broken/Damage/Defect ☐	Weld ☐	Part Incorrect ☐	Crimp/Kink/Ripple/Wave ☐	Inspection Incomplete/Unqualified ☐	Wrong Stock Pulled ☐	Part Lost/Missing ☐	Cuffs ☐	Contamination ☐	Out of Sequence ☐	Part Moved ☐	Crushing ☐	Countersink ☐	Off-set ☐	Drawing ☐	Heat Treat ☐	Cut Too Short ☐	Mislabeled ☐	Finish ☐	Wave/Twist in Tube ☐	Instructions Incomplete/Unclear ☐	Fit/Function ☐	Misread ☐	Marks/Chatter ☐	Drill Holes ☐	Misaligned/off center ☐	Turning Sequence ☐
Environment ☐	No Re-verification ☐	
Design ☒	Operator ☐	
Doc/Data ☐	Offset/Setup ☐	
Equip/Tooling ☐	Supplier ☐	
Handling/Pre ☐	Training ☐	
Material ☐	Use for Testing ☐	
Internal Transport ☐	Poor Information ☐	
Tribal Knowledge ☐	Rushing ☐	
LOA ☐	Product Improvement ☐	
Substation ☐	Process Improvement ☐	
Past Expiry Date ☐	Manufacturing Process ☐	
Misidentified ☐	Past Due ☐	
Pressure/Forced ☐	Temperature/Cure ☐	Power Loss/Surge ☐	Positioned Wrong ☐	
Bending ☐	Set-up ☐	Folio/Program ☐	Outside Dimensions ☐	
Centre Not Concentric ☐	BOM/Route ☐	Grain ☐	Over/Under tolerance ☐	
Cracks ☐	Broken/Damage/Defect ☐	Weld ☐	Part Incorrect ☐	
Crimp/Kink/Ripple/Wave ☐	Inspection Incomplete/Unqualified ☐	Wrong Stock Pulled ☐	Part Lost/Missing ☐	
Cuffs ☐	Contamination ☐	Out of Sequence ☐	Part Moved ☐	
Crushing ☐	Countersink ☐	Off-set ☐	Drawing ☐	
Heat Treat ☐	Cut Too Short ☐	Mislabeled ☐	Finish ☐	
Wave/Twist in Tube ☐	Instructions Incomplete/Unclear ☐	Fit/Function ☐	Misread ☐	
Marks/Chatter ☐	Drill Holes ☐	Misaligned/off center ☐	Turning Sequence ☐	
		OTHER: <u>customer request</u>	

Work Order ID 148006

Friday, June 17, 2016 8:03:12 AM

148006

Page 2

Item ID: D3594-044 Accept ***N900040100*** Setup Start ***NS1***
Revision ID: URF 16-531 Stop ***NS2***
Item Name: Floor Doubler Assembly, RH
Start Date: 7/8/2016 Start Qty: 4.00 ***4*** Cust Item ID:
Required Date: 7/14/2016 Req'd Qty: 4.00 ***4*** Customer:
Reference:

Approvals: Process Plan: _____ Date: _____ Tooling: _____ Date: _____ Run Start ***NR1***
QC: _____ Date: _____ SPC (Y/N): _____ Date: _____ Stop ***NR2***

Sequence ID/ Work Center ID	Operation Description	Set Up/ Run Hours	Tool ID	Tool #	Plan Code	Accept Qty	Reject Qty	Reject Number	Insp. Stamp
130		0.00							
130	Small Fab					7x			16/07/20
Small Fab	Memo	0.02							
Small Fab	C'SINK AS PER DWG D3594								
140		0.00							
140	QC5- Inspect part completeness to step on W/O					②			DAS 36 9-89
QC	Memo	0.01							gave U C - INC.
Quality Control									
150		0.00							
150	Chemical Conversion Coat per QSI005 4.1					⑦			DAS 34 9-89
HandFinish	Memo	0.04							20/6/07/21
Hand Finishing									BEB

H:\FORMS\Quality

DQA: _____ Date: _____



WORK ORDER NON-CONFORMANCE / UPDATE

QA Closed: _____ Date: _____

Work Order update only ☐

Work Order: _____ Part No. _____ NCR No. _____		DISPOSITION Rework ☐ Scrap ☐ Use-as-is ☐ Suspected Unapproved ☐		AGAINST DEPARTMENT/PROCESS Skid-tube ☐ Machining ☐ Thermoforming ☐ Large Fab ☐ Cross tube ☐ Small Fab ☐ Finishing ☐ Composite ☐ Water Jet ☐ Prod. Eng. Coord. ☐ Rec/Store/Packaging ☐ Supplier ☐ Engineering ☐ Quality ☐ Other ☐					
Date :		Step #:		QTY Effective :			MRB (QSI042) Approval Completed By _____ Lead hand / Supervisor Approval Verification _____ QC / QA Coordinator Approval _____		
Description Work Order Deviation				Disposition					

Root Cause				FAULT CATEGORY							
Environment	☐	No Re-verification	☐	Pressure/Forced	☐	Temperature/Cure	☐	Power Loss/Surge	☐	Positioned Wrong	☐
Design	☐	Operator	☐	Bending	☐	Set-up	☐	Folio/Program	☐	Outside Dimensions	☐
Doc/Data	☐	Offset/Setup	☐	Centre Not Concentric	☐	BOM/Route	☐	Grain	☐	Over/Under tolerance	☐
Equip/Tooling	☐	Supplier	☐	Cracks	☐	Broken/Damage/Defect	☐	Weld	☐	Part Incorrect	☐
Handling/Pre	☐	Training	☐	Crimp/Kink/Ripple/Wave	☐	Inspection Incomplete/Unqualified	☐	Wrong Stock Pulled	☐	Part Lost/Missing	☐
Material	☐	Use for Testing	☐	Cuffs	☐	Contamination	☐	Out of Sequence	☐	Part Moved	☐
Internal Transport	☐	Poor Information	☐	Crushing	☐	Countersink	☐	Off-set	☐	Drawing	☐
Tribal Knowledge	☐	Rushing	☐	Heat Treat	☐	Cut Too Short	☐	Mislabeled	☐	Finish	☐
LOA	☐	Product Improvement	☐	Wave/Twist in Tube	☐	Instructions Incomplete/Unclear	☐	Fit/Function	☐	Misread	☐
Substation	☐	Process Improvement	☐	Marks/Chatter	☐	Drill Holes	☐	Misaligned/off center	☐	Turning Sequence	☐
Past Expiry Date	☐	Manufacturing Process	☐	OTHER : _____							
Misidentified	☐	Past Due	☐								

Work Order ID 148006

Friday, June 17, 2016 8:03:12 AM

148006

Page 3

Item ID: D3594-044 Accept ***N900040100*** Setup Start ***NS1***
Revision ID: URF 16-531 Stop ***NS2***
Item Name: Floor Doubler Assembly, RH
Start Date: 7/8/2016 Start Qty: 4.00 ***4*** Cust Item ID:
Required Date: 7/14/2016 Req'd Qty: 4.00 ***4*** Customer:
Reference:

Approvals: Process Plan: _____ Date: _____ Tooling: _____ Date: _____ Run Start ***NR1***
QC: _____ Date: _____ SPC (Y/N): _____ Date: _____ Stop ***NR2***

Sequence ID/ Work Center ID	Operation Description	Set Up/ Run Hours	Tool ID	Tool #	Plan Code	Accept Qty	Reject Qty	Reject Number	Insp. Stamp
160 *160* QC Quality Control	QC7-Inspect Chemical Conversion Coat Memo	0.00 0.01				7	1	lll 12/02/15	DAS 15 9-89
170 *170* Small Fab Small Fab	Small Fab Memo Install Nut Plates As per Dwg D3594	0.00 0.01				7		16/07/21	DAS 36 9-89
180 *180* QC Quality Control	QC5- Inspect part completeness to step on W/O Memo	0.00 0.01				7			DAS 38 9-89 JUL 21 2016

DQA: _____ Date: _____



WORK ORDER NON-CONFORMANCE / UPDATE

QA Closed: _____ Date: _____

Work Order update only ☐

Work Order: _____ Part No. _____ NCR No. _____	DISPOSITION Rework ☐ Scrap ☐ Use-as-is ☐ Suspected Unapproved ☐	AGAINST DEPARTMENT/PROCESS Skid-tube ☐ Machining ☐ Thermoforming ☐ Large Fab ☐ Cross tube ☐ Small Fab ☐ Finishing ☐ Composite ☐ Water Jet ☐ Prod. Eng. Coord. ☐ Rec/Store/Packaging ☐ Supplier ☐ Engineering ☐ Quality ☐ Other ☐			
Date : _____	Step #: _____	QTY Effective : _____		MRB (QSI042) Approval	
Description Work Order Deviation		Disposition		Completed By	
				Lead hand / Supervisor Approval Verification	
				QC / QA Coordinator Approval	
Root Cause Environment ☐ Design ☐ Doc/Data ☐ Equip/Tooling ☐ Handling/Pre ☐ Material ☐ Internal Transport ☐ Tribal Knowledge ☐ LOA ☐ Substation ☐ Past Expiry Date ☐ Misidentified ☐ No Re-verification ☐ Operator ☐ Offset/Setup ☐ Supplier ☐ Training ☐ Use for Testing ☐ Poor Information ☐ Rushing ☐ Product Improvement ☐ Process Improvement ☐ Manufacturing Process ☐ Past Due ☐		FAULT CATEGORY Pressure/Forced ☐ Bending ☐ Centre Not Concentric ☐ Cracks ☐ Crimp/Kink/Ripple/Wave ☐ Cuffs ☐ Crushing ☐ Heat Treat ☐ Wave/Twist in Tube ☐ Marks/Chatter ☐ Temperature/Cure ☐ Set-up ☐ BOM/Route ☐ Broken/Damage/Defect ☐ Inspection Incomplete/Unqualified ☐ Contamination ☐ Countersink ☐ Cut Too Short ☐ Instructions Incomplete/Unclear ☐ Drill Holes ☐ Power Loss/Surge ☐ Folio/Program ☐ Grain ☐ Weld ☐ Wrong Stock Pulled ☐ Out of Sequence ☐ Off-set ☐ Misabeled ☐ Fit/Function ☐ Misaligned/off center ☐ Positioned Wrong ☐ Outside Dimensions ☐ Over/Under tolerance ☐ Part Incorrect ☐ Part Lost/Missing ☐ Part Moved ☐ Drawing ☐ Finish ☐ Misread ☐ Turning Sequence ☐			
OTHER : ☐					

Work Order ID 148006

Friday, June 17, 2016 8:03:12 AM

148006

Page 4

Item ID: D3594-044 Accept ***N900040100*** Setup Start ***NS1***
Revision ID: URF 16-531 Stop ***NS2***
Item Name: Floor Doubler Assembly, RH
Start Date: 7/8/2016 Start Qty: 4.00 ***4*** Cust Item ID:
Required Date: 7/14/2016 Req'd Qty: 4.00 ***4*** Customer:
Reference:

Approvals: Process Plan: _____ Date: _____ Tooling: _____ Date: _____ Run Start ***NR1***
QC: _____ Date: _____ SPC (Y/N): _____ Date: _____ Stop ***NR2***

Sequence ID/ Work Center ID	Operation Description	Set Up/ Run Hours	Tool ID	Tool #	Plan Code	Accept Qty	Reject Qty	Reject Number	Insp. Stamp
190	Identify as per dwg & Stock Location: <i>QC office</i>	0.00							
190									
Packaging	Memo	0.01				<i>7</i>	<i>DAS 5 9-89</i>		<i>JUL 22 2016</i>
Packaging									
200	QC21- Final Inspection - Work Order Release	0.00							
200									
QC	Memo	0.07					<i>DAS 21 9-89</i>		<i>JUL 22 2016</i>
Quality Control									

*DAS
21
9-89**JUL 22 2016*

DQA: _____ Date: _____



WORK ORDER NON-CONFORMANCE / UPDATE

QA Closed: _____ Date: _____

Work Order update only ☐

Work Order: _____ Part No. _____ NCR No. _____	DISPOSITION Rework ☐ Scrap ☐ Use-as-is ☐ Suspected Unapproved ☐	AGAINST DEPARTMENT/PROCESS Skid-tube ☐ Machining ☐ Thermoforming ☐ Large Fab ☐ Cross tube ☐ Small Fab ☐ Finishing ☐ Composite ☐ Water Jet ☐ Prod. Eng. Coord. ☐ Rec/Store/Packaging ☐ Supplier ☐ Engineering ☐ Quality ☐ Other ☐			
Date : _____	Step #: _____	QTY Effective : _____		MRB (QSI042) Approval	
Description Work Order Deviation		Disposition		Completed By	
				Lead hand / Supervisor Approval Verification	
				QC / QA Coordinator Approval	
Root Cause		FAULT CATEGORY			
Environment ☐ Design ☐ Doc/Data ☐ Equip/Tooling ☐ Handling/Pre ☐ Material ☐ Internal Transport ☐ Tribal Knowledge ☐ LOA ☐ Substation ☐ Past Expiry Date ☐ Misidentified ☐ No Re-verification ☐ Operator ☐ Offset/Setup ☐ Supplier ☐ Training ☐ Use for Testing ☐ Poor Information ☐ Rushing ☐ Product Improvement ☐ Process Improvement ☐ Manufacturing Process ☐ Past Due ☐	Pressure/Forced ☐ Bending ☐ Centre Not Concentric ☐ Cracks ☐ Crimp/Kink/Ripple/Wave ☐ Cuffs ☐ Crushing ☐ Heat Treat ☐ Wave/Twist in Tube ☐ Marks/Chatter ☐ Temperature/Cure ☐ Set-up ☐ BOM/Route ☐ Broken/Damage/Defect ☐ Inspection Incomplete/Unqualified ☐ Contamination ☐ Countersink ☐ Cut Too Short ☐ Instructions Incomplete/Unclear ☐ Drill Holes ☐	Power Loss/Surge ☐ Folio/Program ☐ Grain ☐ Weld ☐ Wrong Stock Pulled ☐ Out of Sequence ☐ Off-set ☐ Mislabeled ☐ Fit/Function ☐ Misaligned/off center ☐ Positioned Wrong ☐ Outside Dimensions ☐ Over/Under tolerance ☐ Part Incorrect ☐ Part Lost/Missing ☐ Part Moved ☐ Drawing ☐ Finish ☐ Misread ☐ Turning Sequence ☐			
OTHER : _____					

Picklist Print

Friday, June 17, 2016 8:03:11 AM

Page 1

Work Order ID: 148006

148006

Parent Item: D3594-044

D3594-044

Parent Item Name: Floor Doubler Assembly, RH

Start Date: 7/8/2016

Required Date: 7/14/2016

Start Qty: 4.00

Required Qty: 4.00

Comments: IPP Rev :A New Issue 07-01-22 EC

Component Item ID/ Item Name	Replacement Item ID	Mfg/ Purch	Bin Item	Primary Location	Last Location	Route Seq ID	Unit of Measure	Qty on Hand	Qty per Kit	Total Qty	Qty Issued	Date Issued	Status
M6061T6S.080		Purchased	No			170	sf	269.2000	0.51	2.147368			
									**				
M6061T6S 080													
6061-T6 .080 Sheet													

Location	Loc Qty	Loc Code
MAT020	269.2	

134217	21.6	
m132772	4.3	
m133587	7.7	
m133828	16.3	
m134551	9.3	
m134696	144	
m134830	66	

MS20426AD4-4

Purchased

No

100

Each

4,411.000

2

8

3.9

MS20426AD4-4

Rivet

**

Location	Loc Qty	Loc Code
GA	1962	

125445	1962	
ST312	2449	
m132536	2449	

MS21069-5

Purchased

No

170

Each

74.0000

1

4

MS21069-5

Anchor nuts

**

Location	Loc Qty	Loc Code
ST299	74	

m131920	74	
---------	----	--

PR 2016/07/19

DAS
36
9-89

16/07/21

DAS
36
9-89

16/07/21

14

7

DQA: _____ Date: _____



WORK ORDER NON-CONFORMANCE / UPDATE

QA Closed: _____ Date: _____

Work Order update only ☐

Work Order: _____ Part No. _____ NCR No. _____		DISPOSITION Rework ☐ Scrap ☐ Use-as-is ☐ Suspected Unapproved ☐		AGAINST DEPARTMENT/PROCESS Skid-tube ☐ Machining ☐ Thermoforming ☐ Large Fab ☐ Cross tube ☐ Small Fab ☐ Finishing ☐ Composite ☐ Water Jet ☐ Prod. Eng. Coord. ☐ Rec/Store/Packaging ☐ Supplier ☐ Engineering ☐ Quality ☐ Other ☐					
Date :		Step #:		QTY Effective :			MRB (QSI042) Approval Completed By Lead hand / Supervisor Approval Verification QC / QA Coordinator Approval		
Description Work Order Deviation				Disposition					

Root Cause				FAULT CATEGORY			
Environment	☐	No Re-verification	☐	Pressure/Forced	☐	Temperature/Cure	☐
Design	☐	Operator	☐	Bending	☐	Set-up	☐
Doc/Data	☐	Offset/Setup	☐	Centre Not Concentric	☐	BOM/Route	☐
Equip/Tooling	☐	Supplier	☐	Cracks	☐	Broken/Damage/Defect	☐
Handling/Pre	☐	Training	☐	Crimp/Kink/Ripple/Wave	☐	Inspection Incomplete/Unqualified	☐
Material	☐	Use for Testing	☐	Cuffs	☐	Contamination	☐
Internal Transport	☐	Poor Information	☐	Crushing	☐	Countersink	☐
Tribal Knowledge	☐	Rushing	☐	Heat Treat	☐	Cut Too Short	☐
LOA	☐	Product Improvement	☐	Wave/Twist in Tube	☐	Instructions Incomplete/Unclear	☐
Substation	☐	Process Improvement	☐	Marks/Chatter	☐	Drill Holes	☐
Past Expiry Date	☐	Manufacturing Process	☐	OTHER :			
Misidentified	☐	Past Due	☐				

DART AEROSPACE LTD		Work Order:	148006
Description: Floor Doubler, RH		Part Number:	D3594-4
Inspection Dwg: D3594 Rev: B		Page 1 of 1	


FIRST ARTICLE INSPECTION CHECKLIST

☒ First Article ☐ Prototype


Drawing Dimension	Tolerance	Actual Dimension	Accept	Reject	Method of Inspection	Comments
12.50 ⁵⁰	+/-0.030	12.50	✓		tape	
7.85	+/-0.030	7.848	✓		Dc-01	
7.57 ⁵⁰	+/-0.010	7.570	✓		Dc-02	
2.688	+/-0.010	2.690	✓			
Ø0.323	+0.006/-0.001	0.325	✓			
Ø0.128	+0.005/-0.001	0.130	✓			
0.359	+/-0.010	0.360	✓			
0.718	+/-0.010	0.721	✓			
0.81	+/-0.030	0.815	✓			
2.57 ⁵⁰	+/-0.030	2.577	✓			
0.080	+/-0.010	0.080	✓			
2066/7/19 12.75	±0.030	12.75	✓		tape	
7.85	±0.030	7.845	✓		Dc-01	
7.563	±0.010	7.566	✓			
2.688	±0.010	2.693	✓			
Ø0.323	+0.006 -0.001	0.326	✓			
Ø0.128	+0.005 -0.001	0.131	✓			
0.359	±0.010	0.358	✓			
0.718	±0.010	0.721	✓			
0.81	±0.030	0.818	✓			
2.57	±0.030	2.584	✓			
0.080	±0.010	0.081	✓			

Measured by: PH 38 9-89	Audited by: DAS 9 9-89	Prototype Approval:	N/A
Date: 2016/07/19	Date: 16-09-23	Date:	N/A


Rev	Date	Change	Revised by	Approved
A	07.07.18	New Issue P/O D3594-044	KJ/JLM	
B	09.05.07	Dimensions updated per Dwg Rev B	KJ/EC	

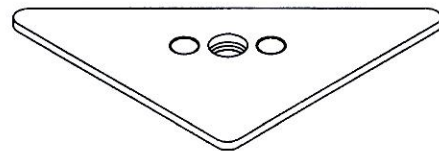


D3594-041 DOOR DOUBLER ASSEMBLY

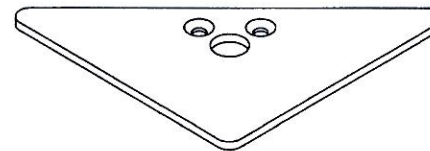

D3594-5 DOOR DOUBLER

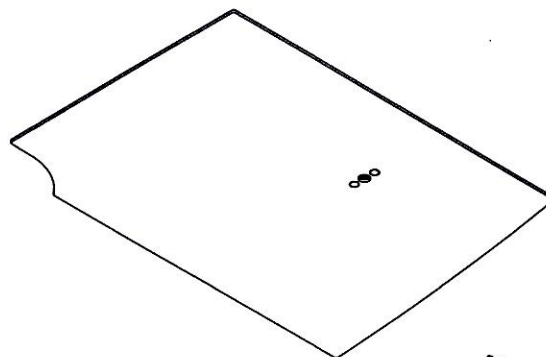

D3594-043 FLOOR DOUBLER ASSEMBLY

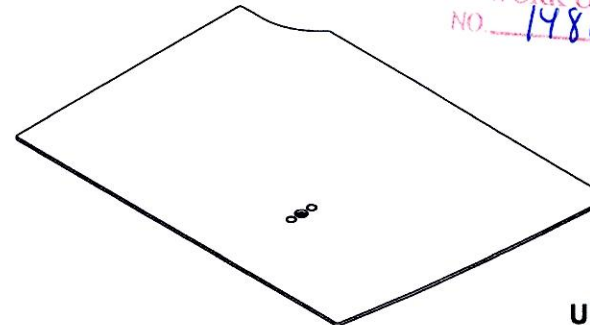

D3594-044 FLOOR DOUBLER ASSEMBLY

SHOP COPY
RETURN TO
ENGINEERING
UNCONTROLLED COPY
SUBJECT TO AMENDMENT
WITHOUT NOTICE
WORK ORDER
NO. 148006 MCG
160621



UNDER REVIEW

URF 16-531 MB


RELEASED
080526

B	REFORMAT TO B SIZE DRAWING. SHEET 2 ADD -5.	AJS	08.05.14
A	NEW ISSUE	MB	07.04.13
REV.	DESCRIPTION	BY	DATE
DESIGN	MB		
DRAWN	AJS		
CHECKED			
MFG. APPR.			
APPROVED			
DE APPR.			
DATE	08.05.14		
DART AEROSPACE LTD HAWKESBURY, ONTARIO, CANADA DRAWING NO. D3594 TITLE DOUBLER SCALE NTS REV. B SHEET 1 OF 4 COPYRIGHT © 2007 BY DART AEROSPACE LTD THIS DOCUMENT IS PRIVATE AND CONFIDENTIAL AND IS SUPPLIED ON THE EXPRESS CONDITION THAT IT IS NOT TO BE USED FOR ANY PURPOSE OR COPIED OR COMMUNICATED TO ANY OTHER PERSON WITHOUT WRITTEN PERMISSION FROM DART AEROSPACE LTD.			


QTY. -041	PART NUMBER	DESCRIPTION
X	D3594-041	DOOR DOUBLER ASSEMBLY
1	D3594-1	DOOR DOUBLER
1	MS21069L5	ANCHOR NUT
2	MS20426AD4-4	RIVET, CSK

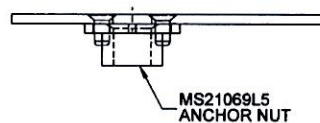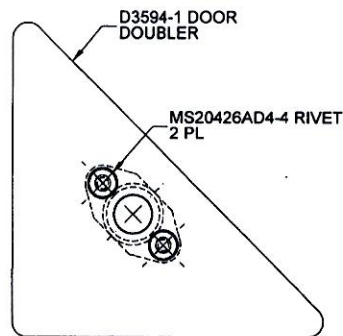


4 D3594-041 DOOR DOUBLER ASSEMBLY

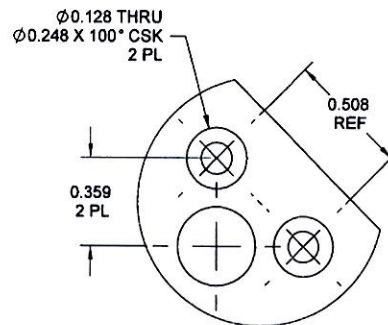

DETAIL A
SCALE 2X

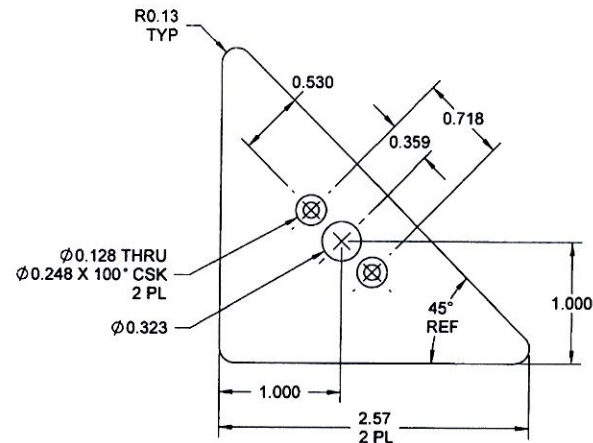

D3594-1 DOOR DOUBLER

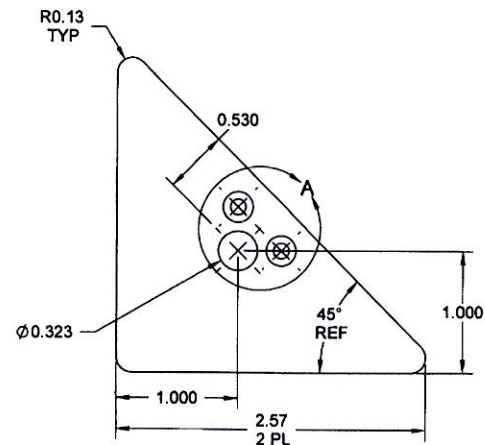

5 D3594-5 DOOR DOUBLER

UNDER REVIEW
URF 16-531 MB


RELEASED
08.05.14

NOTES:


- 1) MATERIAL: -1 & -5
6061-T6 (OR 6061-T62) ALUMINUM SHEET, 0.080 THICK,
PER AMS-QQ-A-250/11 OR AMS 4025 OR AMS 4027
(REF. DART SPEC. M6061T6S.080)
- 2) FINISH: CHEMICAL CONVERSION COAT PER DART QSI 005 4.1
- 3) TOLERANCES ARE PER DART QSI 018 UNLESS OTHERWISE NOTED
- 4) IDENTIFY WITH DART P/N "D3594-041" USING FINE POINT PERMANENT INK MARKER
- 5) IDENTIFY WITH DART P/N "D3594-5" USING FINE POINT PERMANENT INK MARKER
- 6) ALL DIMENSIONS ARE IN INCHES UNLESS OTHERWISE NOTED
- 7) BREAK ALL SHARP EDGES 0.005 TO 0.010 MAX
- 7) WEIGHT -041: 0.04 lbs
-5: 0.03 lbs

DESIGN	MB	DART AEROSPACE LTD HAWKESBURY, ONTARIO, CANADA	
DRAWN	AUS		
CHECKED		DRAWING NO. D3594	REV. B SHEET 2 OF 4
MFG. APPR.		TITLE DOUBLER	SCALE NTS
APPROVED		COPYRIGHT © 2007 BY DART AEROSPACE LTD THIS DOCUMENT IS PRIVATE AND CONFIDENTIAL AND IS SUPPLIED ON THE EXPRESS CONDITION THAT IT IS NOT TO BE USED FOR ANY PURPOSE OR COPIED OR DISSEMINATED TO ANY OTHER PERSON WITHOUT WRITTEN PERMISSION FROM DART AEROSPACE LTD.	
DE APPR.			
DATE	08.05.14		


QTY. -043	QTY. -044	PART NUMBER	DESCRIPTION
X		D3594-043	FLOOR DOUBLER ASSEMBLY, LH
	X	D3594-044	FLOOR DOUBLER ASSEMBLY, RH
1		D3594-3	FLOOR DOUBLER, LH
	1	D3594-4	FLOOR DOUBLER, RH
1	1	MS21069L5	ANCHOR NUT
2	2	MS20426AD4-4	RIVET, CSK

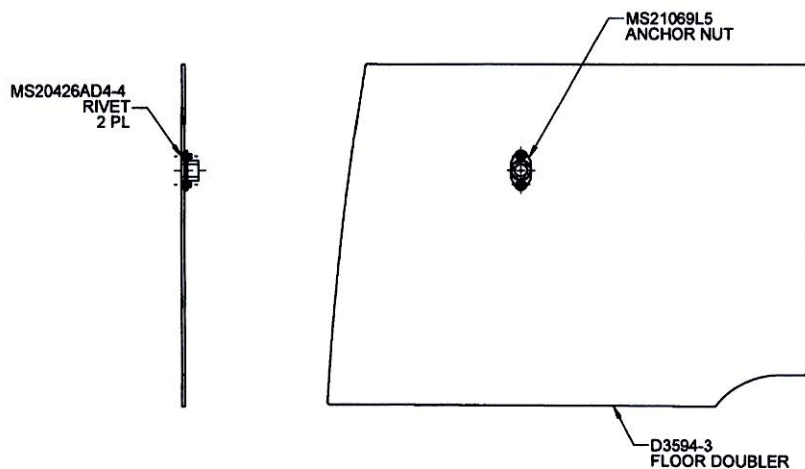

D3594-043 FLOOR DOUBLER ASSEMBLY

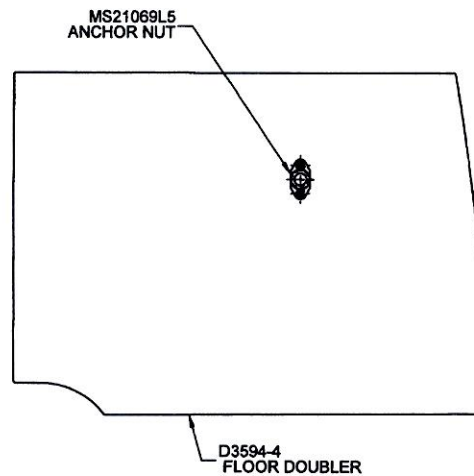

D3594-044 FLOOR DOUBLER ASSEMBLY

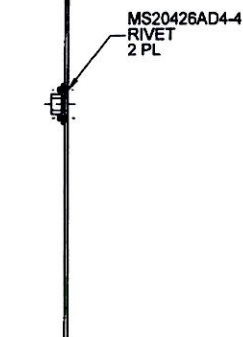

UNDER REVIEW


URF 16-531 MB

RELEASED
08-06-25-14


NOTES:

- 1) MATERIAL: -3 & -4
6061-T6 (OR 6061-T62) ALUMINUM SHEET, 0.080 THICK,
PER AMS-QQ-A-250/11 OR AMS 4025 OR AMS 4027
(REF. DART SPEC. M6061T6S.080)
- 2) FINISH: CHEMICAL CONVERSION COAT PER DART QSI 005 4.1
- 3) TOLERANCES ARE PER DART QSI 018 UNLESS OTHERWISE NOTED
- 4) IDENTIFY WITH DART P/N "D3594-043/-044" USING FINE POINT PERMANENT INK MARKER
- 5) ALL DIMENSIONS ARE IN INCHES UNLESS OTHERWISE NOTED
- 6) BREAK ALL SHARP EDGES 0.005 TO 0.010 MAX
- 7) WEIGHT -043 & -044: 0.80 lbs

DESIGN	MB	DART AEROSPACE LTD	
DRAWN	AJS	HAWKESBURY, ONTARIO, CANADA	
CHECKED		DRAWING NO.	REV. B
MFG. APPR.		D3594	SHEET 3 OF 4
APPROVED		TITLE	SCALE
DE APPR.		DOUBLER	NTS
DATE	08.05.14	COPYRIGHT © 2007 BY DART AEROSPACE LTD	
THIS DOCUMENT IS PRIVATE AND CONFIDENTIAL AND IS SUPPLIED ON THE EXPRESS CONDITION THAT IT IS NOT TO BE USED FOR ANY PURPOSE OR COPIED OR COMMUNICATED TO ANY OTHER PERSON WITHOUT WRITTEN PERMISSION FROM DART AEROSPACE LTD.			

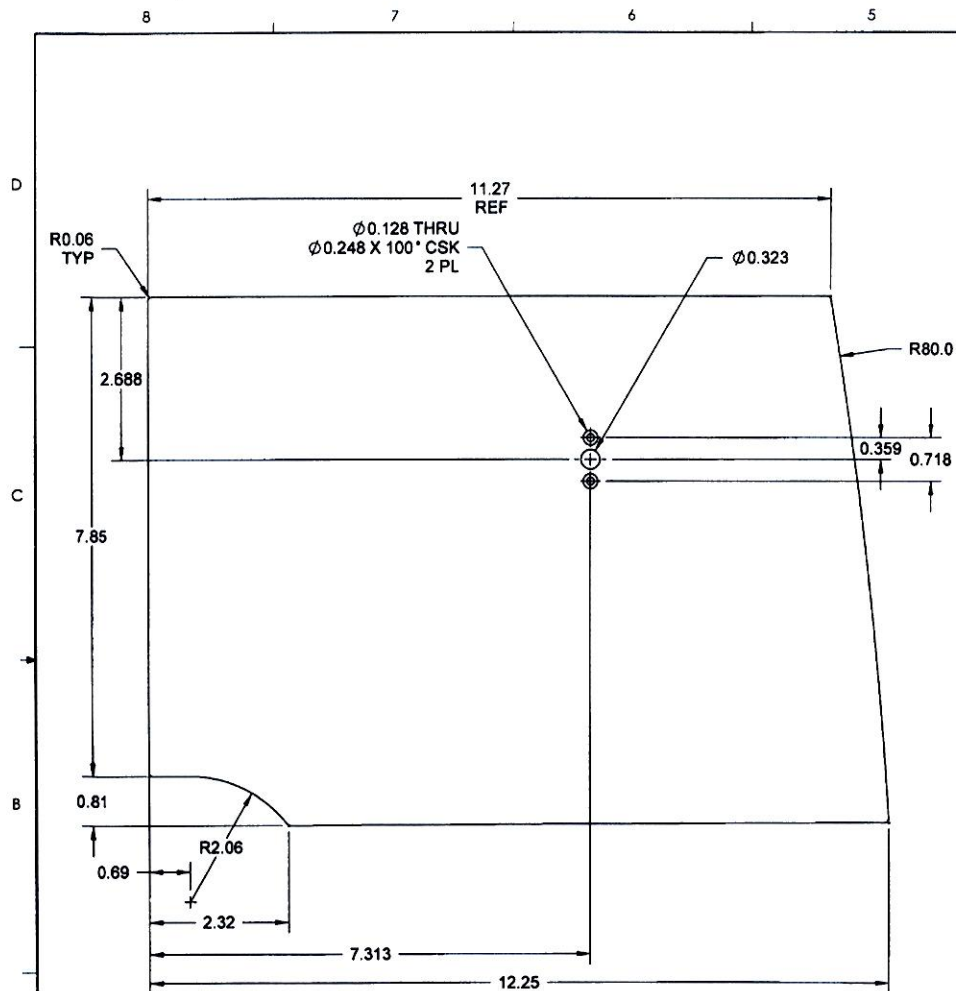

D3594-3 FLOOR DOUBLER

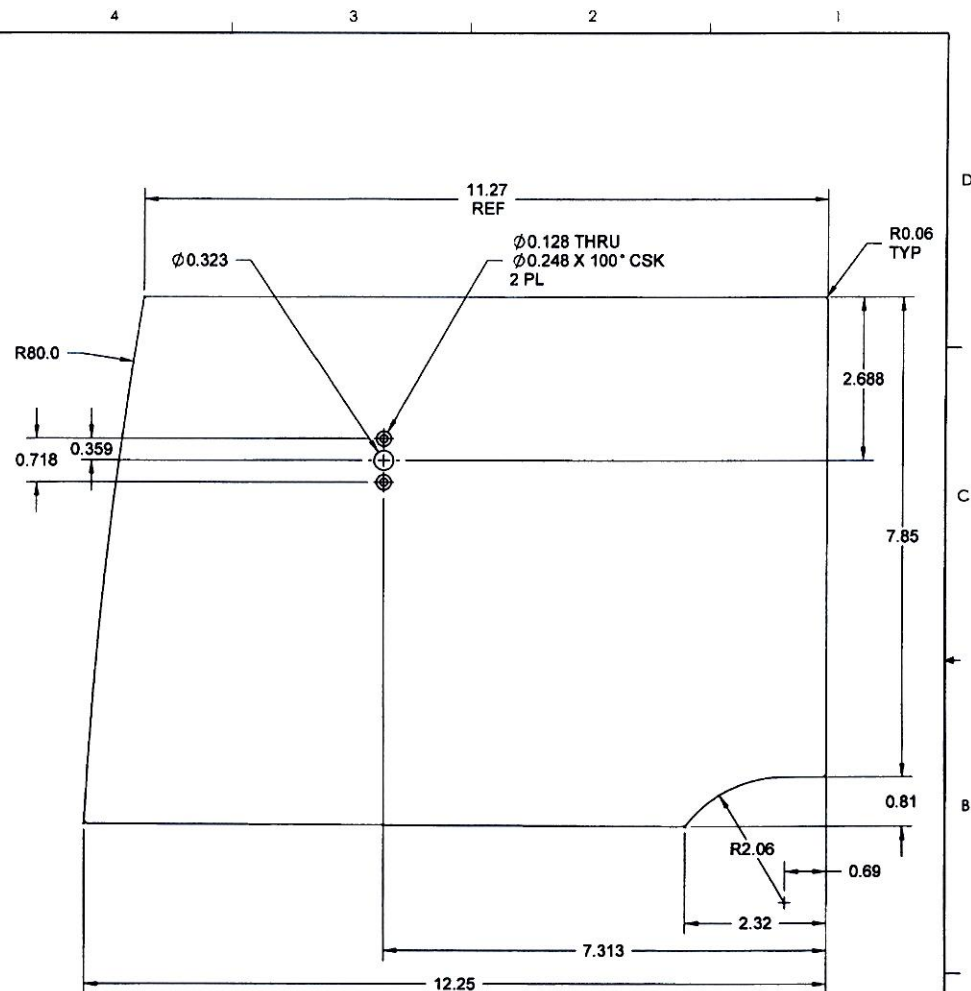

D3594-4 FLOOR DOUBLER

UNDER REVIEW

URF 16-531 MB

RELEASED
08 05 14

DESIGN	AJS	DART AEROSPACE LTD HAWKESBURY, ONTARIO, CANADA	
DRAWN	MB		
CHECKED		DRAWING NO.	REV. B
MFG. APPR.		D3594	SHEET 4 OF 4
APPROVED		TITLE	SCALE
DE APPR.		DOOR DOUBLER ASSEMBLY	NTS
DATE	08.05.14	COPYRIGHT © 2007 BY DART AEROSPACE LTD THIS DOCUMENT IS PRIVATE AND CONFIDENTIAL AND IS SUPPLIED ON THE EXPRESS CONDITION THAT IT IS NOT TO BE USED FOR ANY PURPOSE OR COPIED OR COMMUNICATED TO ANY OTHER PERSON WITHOUT WRITTEN PERMISSION FROM DART AEROSPACE LTD.	

148 006
S# 7/13/16

Under Review Notification

Raised By: M. BELLAVANCE

Product #: D412-698-023

Date: 16.02.25


Product Name: AUTOMATIC DOOR OPENER KIT

Part Number (D-Part and 9-Digit)	Drawing/Document & Current Affected Revision	"Y" or "N" Required for Each Part							Reserved ECN Log Number	Instructions Relevant to Each Part
		HOLD SHIPMENT	Red Tag/Quarantine Stock	Advise Customers	Stop Production	Re-Work Stock	IPP Under Review	Product Specifications Under Review		
D3594-043/-044/-3/-4	D3594 Rev. B	N	Y	N	Y	N	Y	N	16-531	See below.
D412-698-023	IIN-D412-698 Rev. E	N	Y	N	Y	N	Y	N	16-531	See below.


Description of Issue:

Current stock OK to ship to customers other than Bell Helicopter Mirabel.


If shipping to Bell Helicopter Mirabel: must ship D412-698-023 with enlarged D3594-043/-044/-3/-4. Eng. To sign off deviations on W/Os.
Change: addition of material, 0.25", on the inboard and outboard edges as shown to facilitate installation with existing equipment.

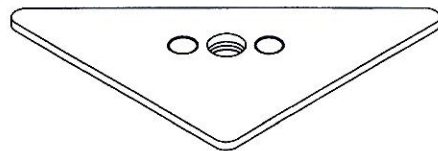


D3594-041 DOOR DOUBLER ASSEMBLY

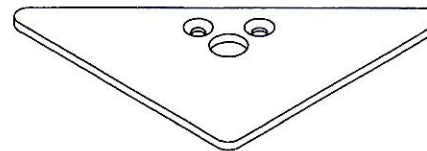

D3594-5 DOOR DOUBLER

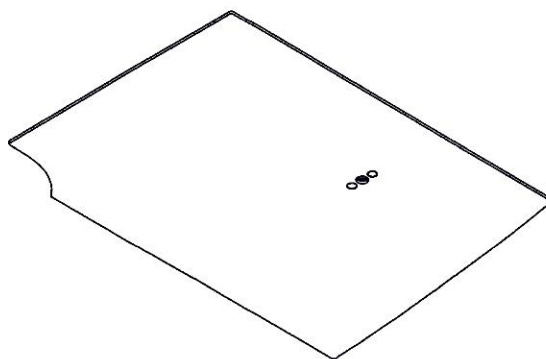

D3594-043 FLOOR DOUBLER ASSEMBLY


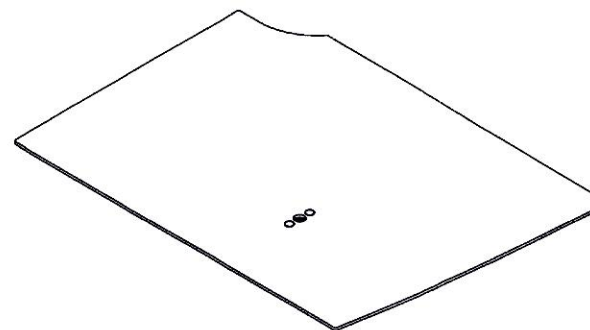


D3594-044 FLOOR DOUBLER ASSEMBLY


RELEASED
08.05.14

B	REFORMAT TO B SIZE DRAWING. SHEET 2 ADD -5.	AJS	08.05.14
A	NEW ISSUE	MB	07.04.13
REV.	DESCRIPTION	BY	DATE
DESIGN	MB	DART AEROSPACE LTD HAWKESBURY, ONTARIO, CANADA	
DRAWN	AJS		
CHECKED		DRAWING NO.	REV. B
MFG. APPR.		D3594	SHEET 1 OF 4
APPROVED		TITLE	SCALE
DE APPR.		DOUBLER	NTS
DATE	08.05.14	COPYRIGHT © 2007 BY DART AEROSPACE LTD THIS DOCUMENT IS PRIVATE AND CONFIDENTIAL AND IS SUPPLIED ON THE EXPRESS CONDITION THAT IT IS NOT TO BE USED FOR ANY PURPOSE OR COPIED OR COMMUNICATED TO ANY OTHER PERSON WITHOUT WRITTEN PERMISSION FROM DART AEROSPACE LTD.	


QTY. -041	PART NUMBER	DESCRIPTION
X	D3594-041	DOOR DOUBLER ASSEMBLY
1	D3594-1	DOOR DOUBLER
1	MS21069L5	ANCHOR NUT
2	MS20426AD4-4	RIVET, CSK

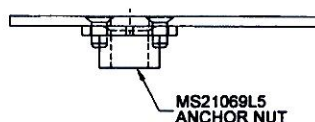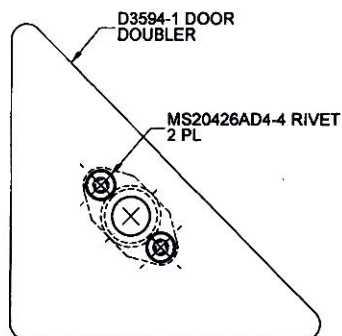


4 D3594-041 DOOR DOUBLER ASSEMBLY

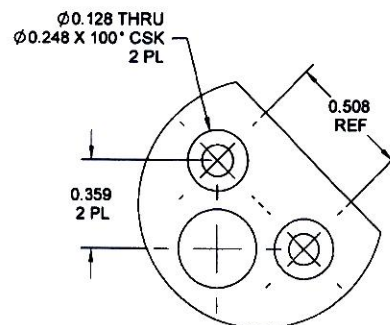

DETAIL A
SCALE 2X

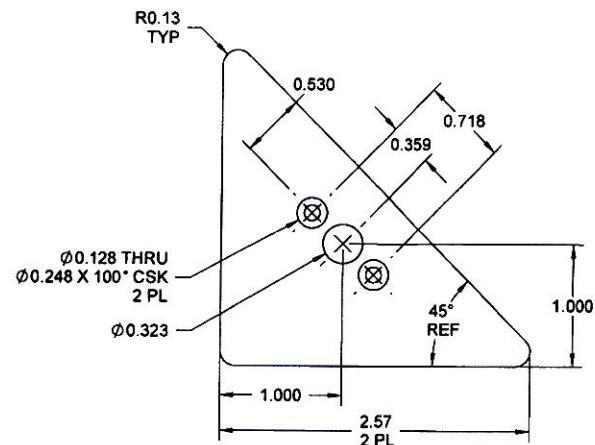

D3594-1 DOOR DOUBLER

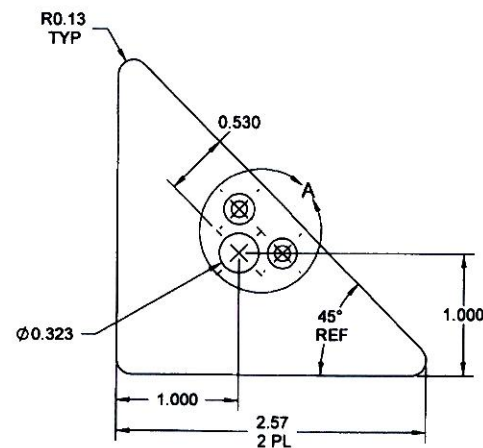

5 D3594-5 DOOR DOUBLER B


NOTES:

- 1) MATERIAL: -1 & -5
6061-T6 (OR 6061-T62) ALUMINUM SHEET, 0.080 THICK,
PER AMS-QQ-A-250/11 OR AMS 4025 OR AMS 4027
(REF. DART SPEC. M6061T6S.080)
- 2) FINISH: CHEMICAL CONVERSION COAT PER DART QSI 005 4.1
- 3) TOLERANCES ARE PER DART QSI 018 UNLESS OTHERWISE NOTED
- 4) IDENTIFY WITH DART P/N "D3594-041" USING FINE POINT PERMANENT INK MARKER
- 5) IDENTIFY WITH DART P/N "D3594-5" USING FINE POINT PERMANENT INK MARKER
- 6) ALL DIMENSIONS ARE IN INCHES UNLESS OTHERWISE NOTED
- 7) BREAK ALL SHARP EDGES 0.005 TO 0.010 MAX
- 7) WEIGHT -041: 0.04 lbs
-5: 0.03 lbs


RELEASED
08-05-14

DESIGN	MB	DART AEROSPACE LTD	
DRAWN	AUS	HAWKESBURY, ONTARIO, CANADA	
CHECKED		DRAWING NO.	REV. B
MFG. APPR.		D3594	SHEET 2 OF 4
APPROVED		TITLE	SCALE
DE APPR.		DOUBLER	NTS
DATE	08.05.14	COPYRIGHT © 2007 BY DART AEROSPACE LTD	
THIS DOCUMENT IS PRIVATE AND CONFIDENTIAL AND IS SUPPLIED ON THE EXPRESS CONDITION THAT IT IS NOT TO BE USED FOR ANY PURPOSE OR COPIED OR COMMUNICATED TO ANY OTHER PERSON WITHOUT WRITTEN PERMISSION FROM DART AEROSPACE LTD			

QTY. -043	QTY. -044	PART NUMBER	DESCRIPTION
X		D3594-043	FLOOR DOUBLER ASSEMBLY, LH
	X	D3594-044	FLOOR DOUBLER ASSEMBLY, RH
1		D3594-3	FLOOR DOUBLER, LH
	1	D3594-4	FLOOR DOUBLER, RH
1	1	MS21069L5	ANCHOR NUT
2	2	MS20426AD4-4	RIVET, CSK

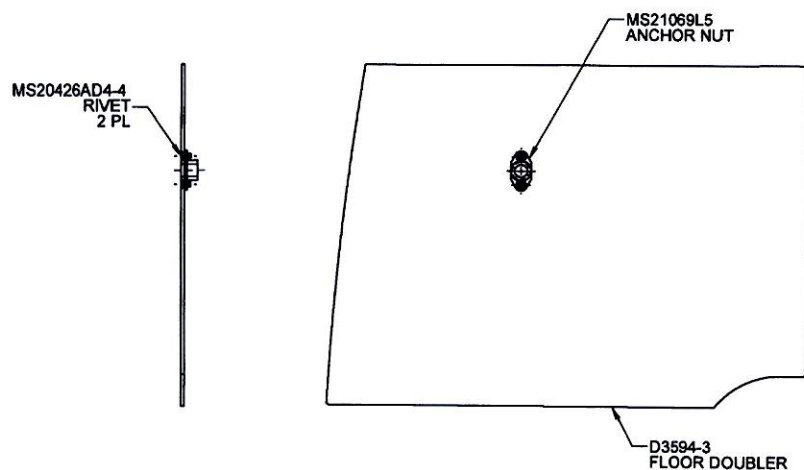

D3594-043 FLOOR DOUBLER ASSEMBLY

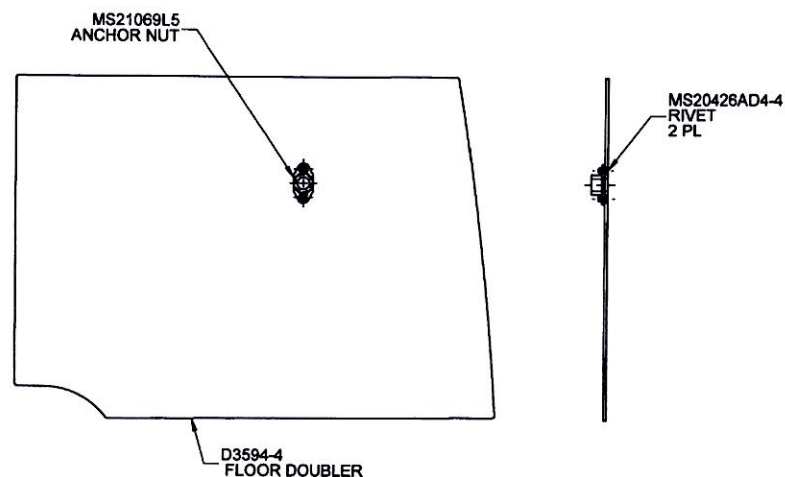


D3594-044 FLOOR DOUBLER ASSEMBLY

NOTES:

- 1) MATERIAL: -3 & -4
6061-T6 (OR 6061-T62) ALUMINUM SHEET, 0.080 THICK,
PER AMS-QQ-A-250/11 OR AMS 4025 OR AMS 4027
(REF. DART SPEC. M6061T6S.080)
- 2) FINISH: CHEMICAL CONVERSION COAT PER DART QSI 005 4.1
- 3) TOLERANCES ARE PER DART QSI 018 UNLESS OTHERWISE NOTED
- 4) IDENTIFY WITH DART P/N "D3594-043/-044" USING FINE POINT PERMANENT INK MARKER
- 5) ALL DIMENSIONS ARE IN INCHES UNLESS OTHERWISE NOTED
- 6) BREAK ALL SHARP EDGES 0.005 TO 0.010 MAX
- 7) WEIGHT -043 & -044: 0.80 lbs


DESIGN	MB	DART AEROSPACE LTD HAWKESBURY, ONTARIO, CANADA	
DRAWN	AJS		
CHECKED	J	DRAWING NO. D3594	REV. B
MFG. APPR.	NS	SHEET 3 OF 4	
APPROVED	12	TITLE	SCALE
DE APPR.	12	DOUBLER	NTS
DATE	08.05.14	COPYRIGHT © 2007 BY DART AEROSPACE LTD THIS DOCUMENT IS PRIVATE AND CONFIDENTIAL AND IS SUPPLIED ON THE EXPRESS CONDITION THAT IT IS NOT TO BE USED FOR ANY PURPOSE OR COPIED OR COMMUNICATED TO ANY OTHER PERSON WITHOUT WRITTEN PERMISSION FROM DART AEROSPACE LTD.	

RELEASED
178.06.2.12

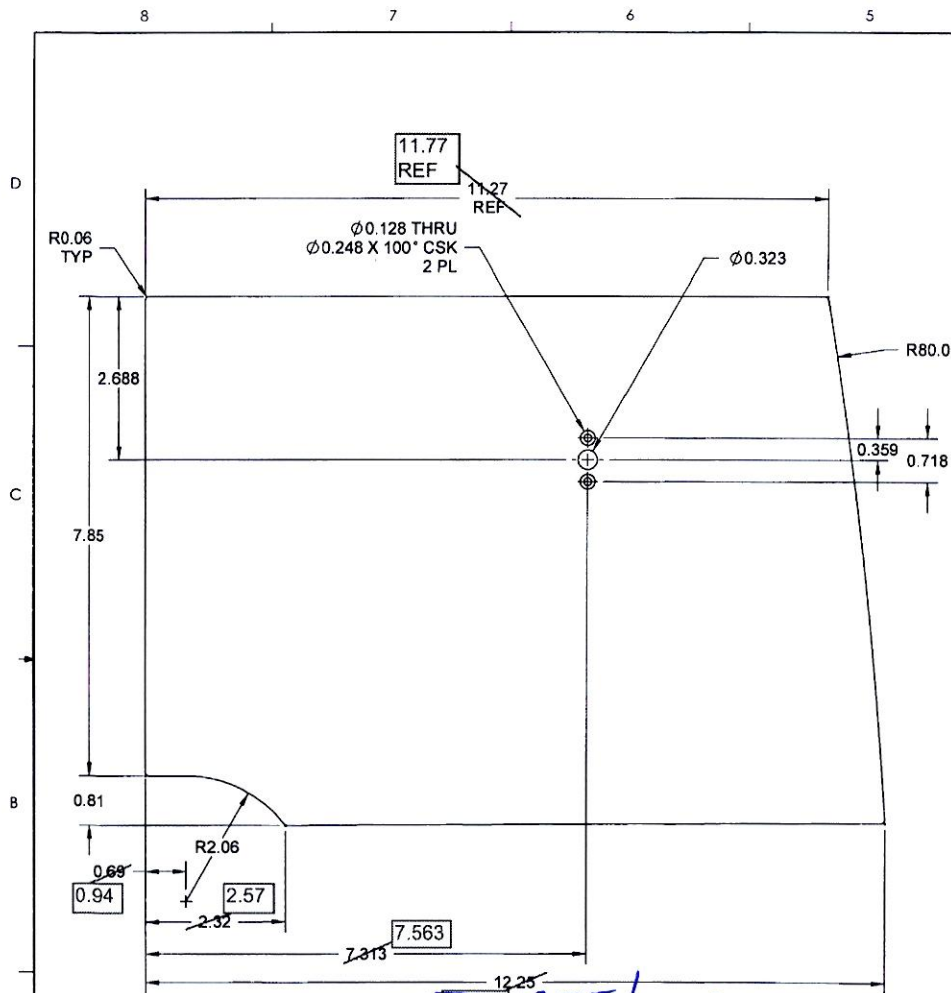

D3594-3 FLOOR DOUBLER

12.75 1316.07.18
051042

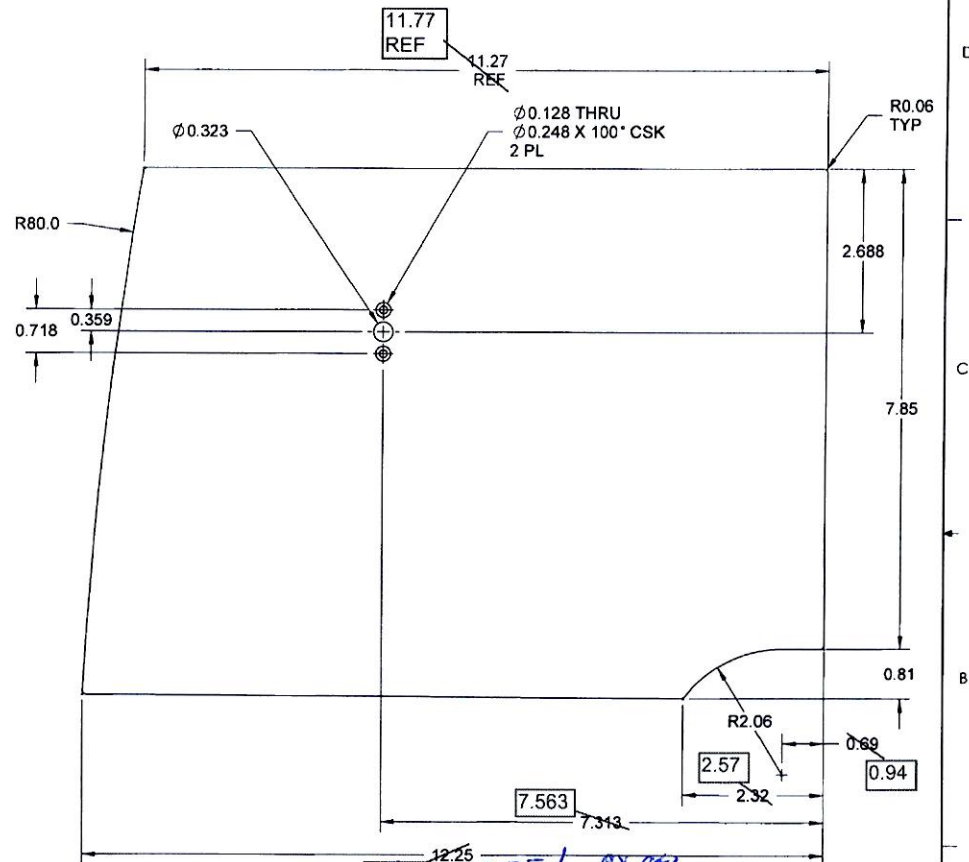

D3594-4 FLOOR DOUBLER

DESIGN	AJS	DART AEROSPACE LTD HAWKESBURY, ONTARIO, CANADA	
DRAWN	MB		
CHECKED		DRAWING NO.	REV. B
MFG. APPR.		D3594	SHEET 4 OF 4
APPROVED		TITLE	SCALE
DE APPR.		DOOR DOUBLER ASSEMBLY	NTS
DATE	08.05.14	COPYRIGHT © 2007 BY DART AEROSPACE LTD THIS DOCUMENT IS PRIVATE AND CONFIDENTIAL AND IS SUPPLIED ON THE EXPRESS CONDITION THAT IT IS NOT TO BE USED FOR ANY PURPOSE OR COPIED OR COMMUNICATED TO ANY OTHER PERSON WITHOUT WRITTEN PERMISSION FROM DART AEROSPACE LTD.	

RELEASED
08.05.14

16/7/15